

ALEXCO RESOURCE CORP
BELLKENO MINE


DEPT.	APPROVED BY	DATE	COMMENTS
SURVEY			
ENGINEERING			
GEOLOGY			
ALEXCO MANAGER			
PROCON SUPER			

TITLE: ONEK 990 PORTAL	
Site Layout and 2012 Development	
2012 YTD	
Drawn by: TRAVIS MURPHY	Scale: 1:500
Date: 01/18/2013	Approval: _____ Date: _____
File: C:\Users\Travis.Murphy\Desktop\Onek contours Jan17 2013.dwg	

Onek

3 Jan. 2013

O/S:

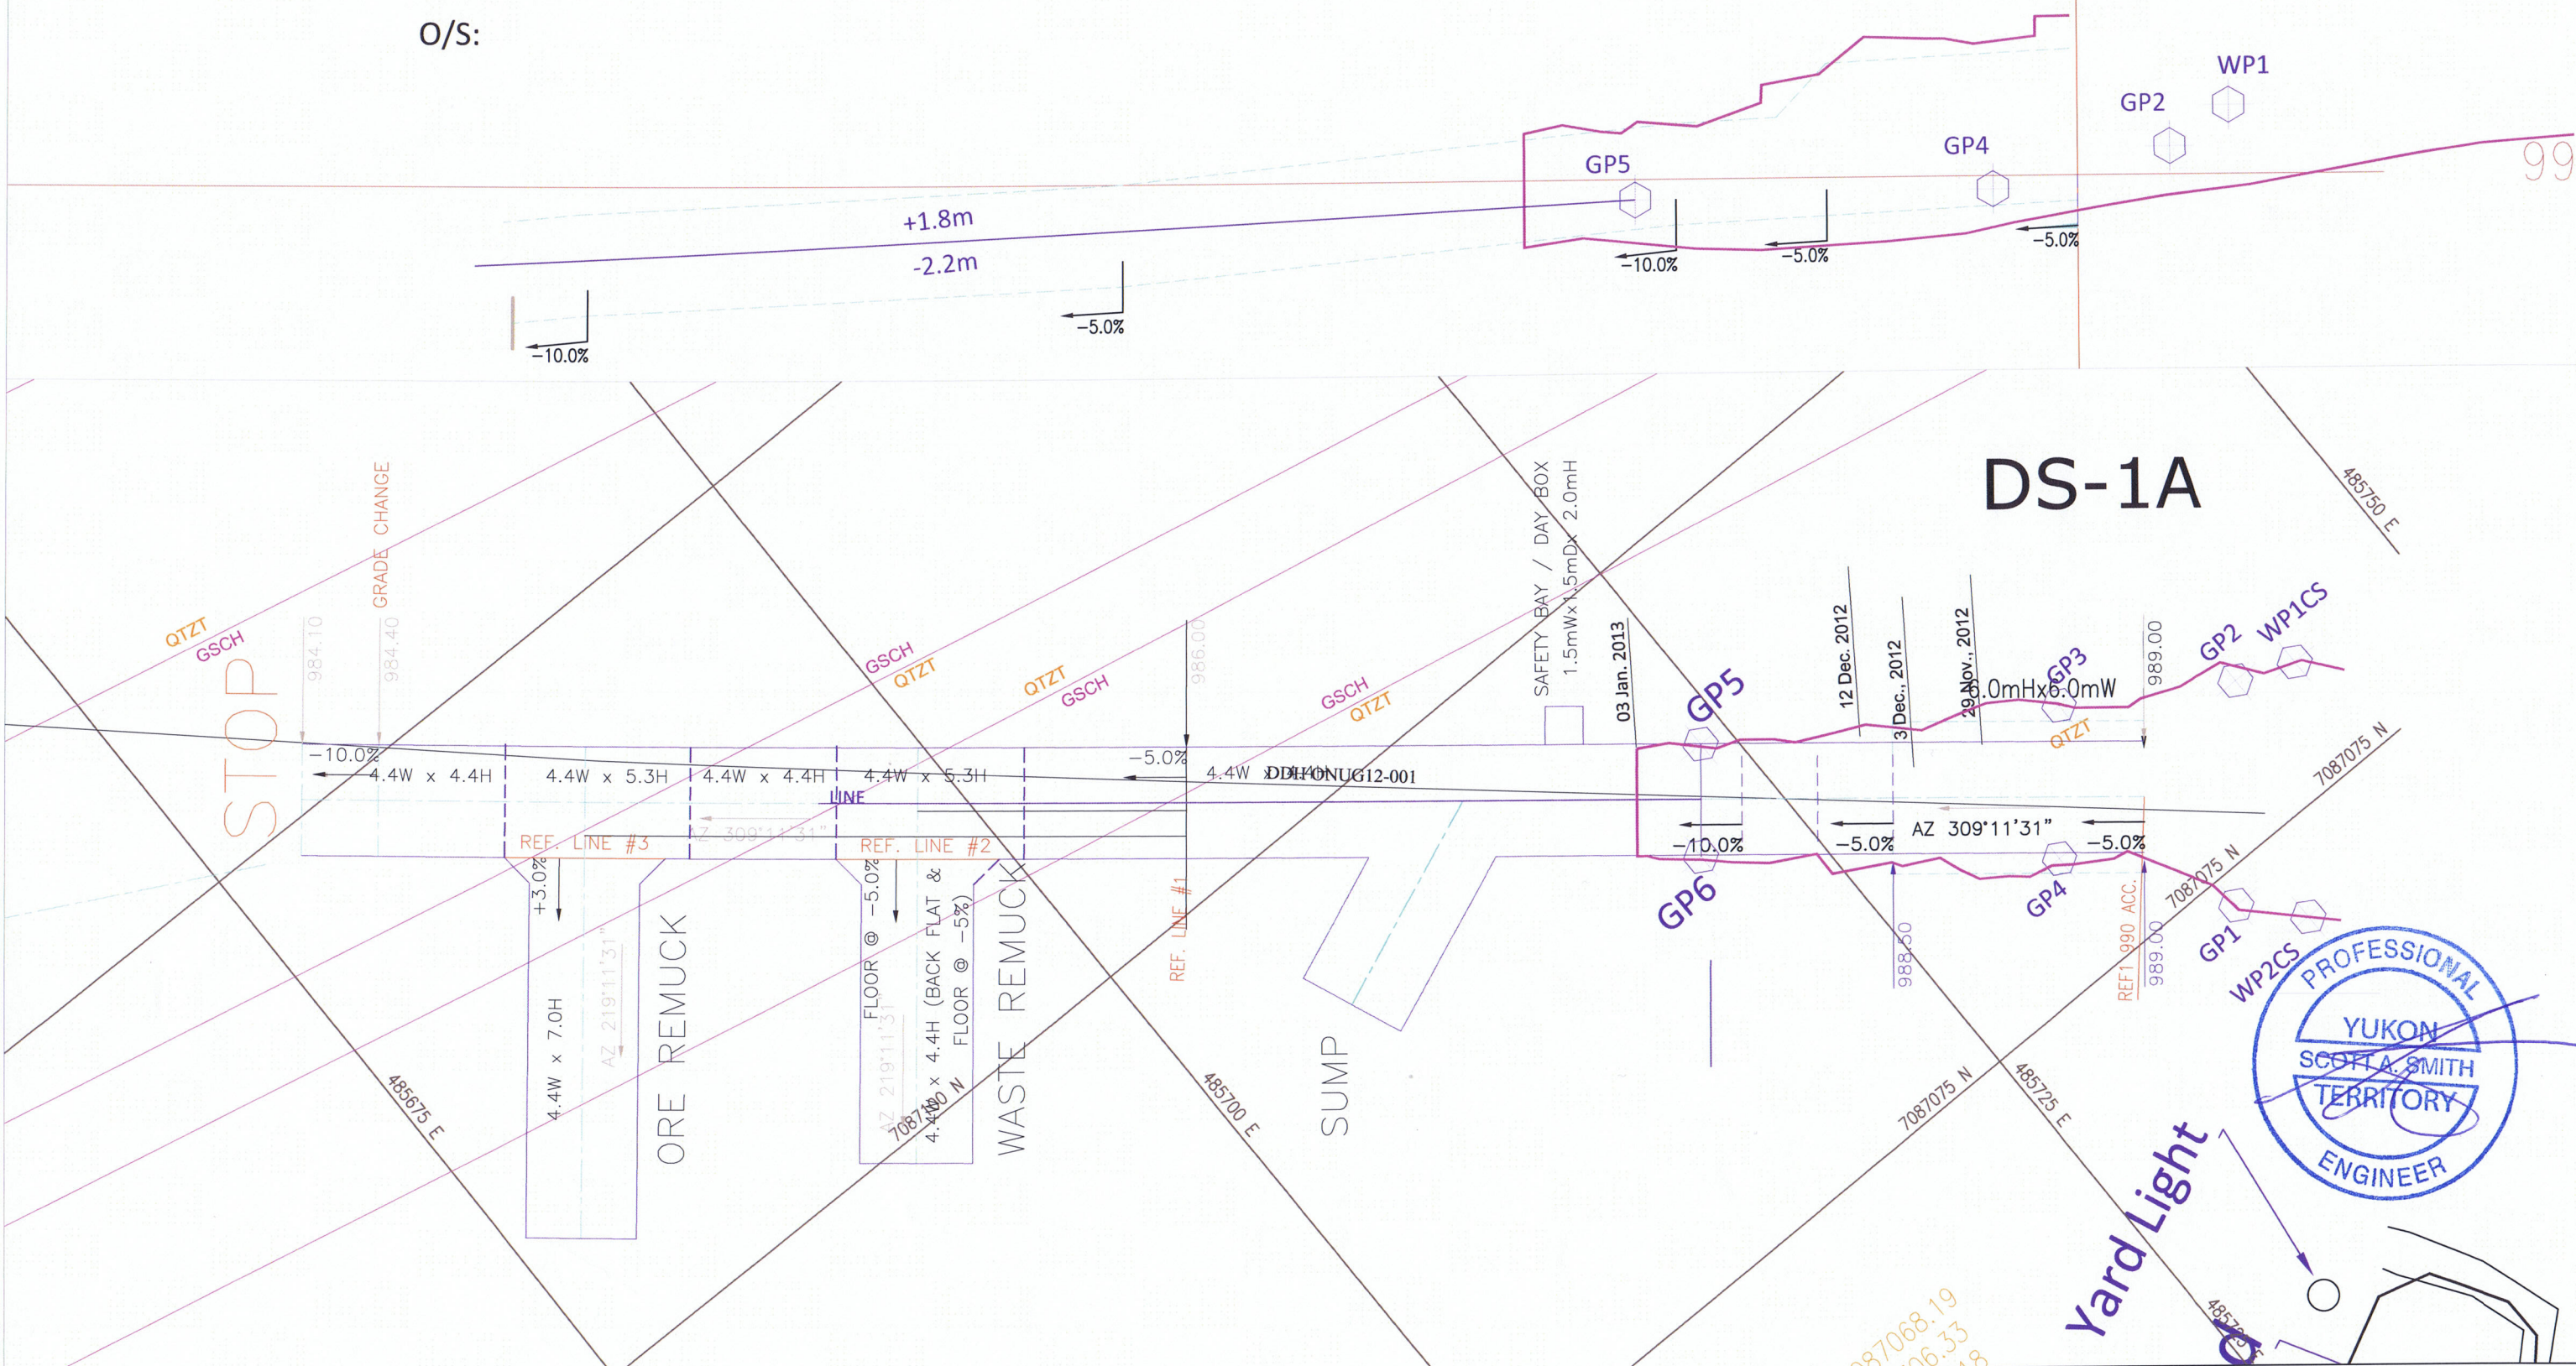

DS-1A

<p>ALEXCO</p>	ALEXCO RESOURCE CORP		DEPT.	APPROVED BY	DATE	COMMENTS	TITLE:
	BELLKENO MINE		SURVEY				Onek
			ENGINEERING				Main Ramp
			GEOLOGY				Drawn by: D. Donison
			ALEXCO MANAGER				Scale: 1:250
		PROCON SUPER				Date: Jan. 11, 2013	
						Approval: _____	
						Date: _____	
						File: ONEK Drive Print.dwg	