


Aerial photography flight date: July 13th 2006. Ortho-rectification produced by Challenger Geomatics Ltd. Data obtained from EBA: "As built" spatial data: Mill pond (Y.E.S.), Mill structure, and current DSTF footprints, Roads (In House survey December 11th 2011). Design spatial data: Conveyance and water collection, diversion ditches and berm.

Datum: NAD 83; Projection: UTM Zone 8N

This drawing has been prepared for the use of Access Mining Consultants Ltd.'s client and may not be used, reproduced or relied upon by third parties, except as agreed by Access Mining Consultants Ltd. and its client, as required by law or for use of governmental reviewing agencies. Access Mining Consultants Ltd. accepts no responsibility, and denies any liability whatsoever, to any party that modifies this drawing without Access Mining Consultants Ltd.'s express written consent.

Main Map: 1:3,000 Inset Map: 1:50,000
(when printed on 11 x17 inch paper)

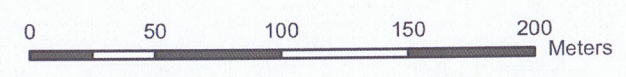

- Dry Stack Tailings
- Design PU
- AsBuilt; As Built
- Mill Access Road
- Haul Road
- Local Road



BELLEKENO MINE		
MILL AREA AS-BUILT		
Drawn By JP	MARCH 2012	Verified by VB
I:\ALEX-05-01\Bellekeno\GIS\mxd\Annual_Reports\2011\MillSite_Layout_20120307.mxd (Last edited by: jpan; 3/7/2012 13:56 PM)		